



# AS-BUILT LOWER LEVEL PLAN

SCALE: 1/4" = 1'-0"

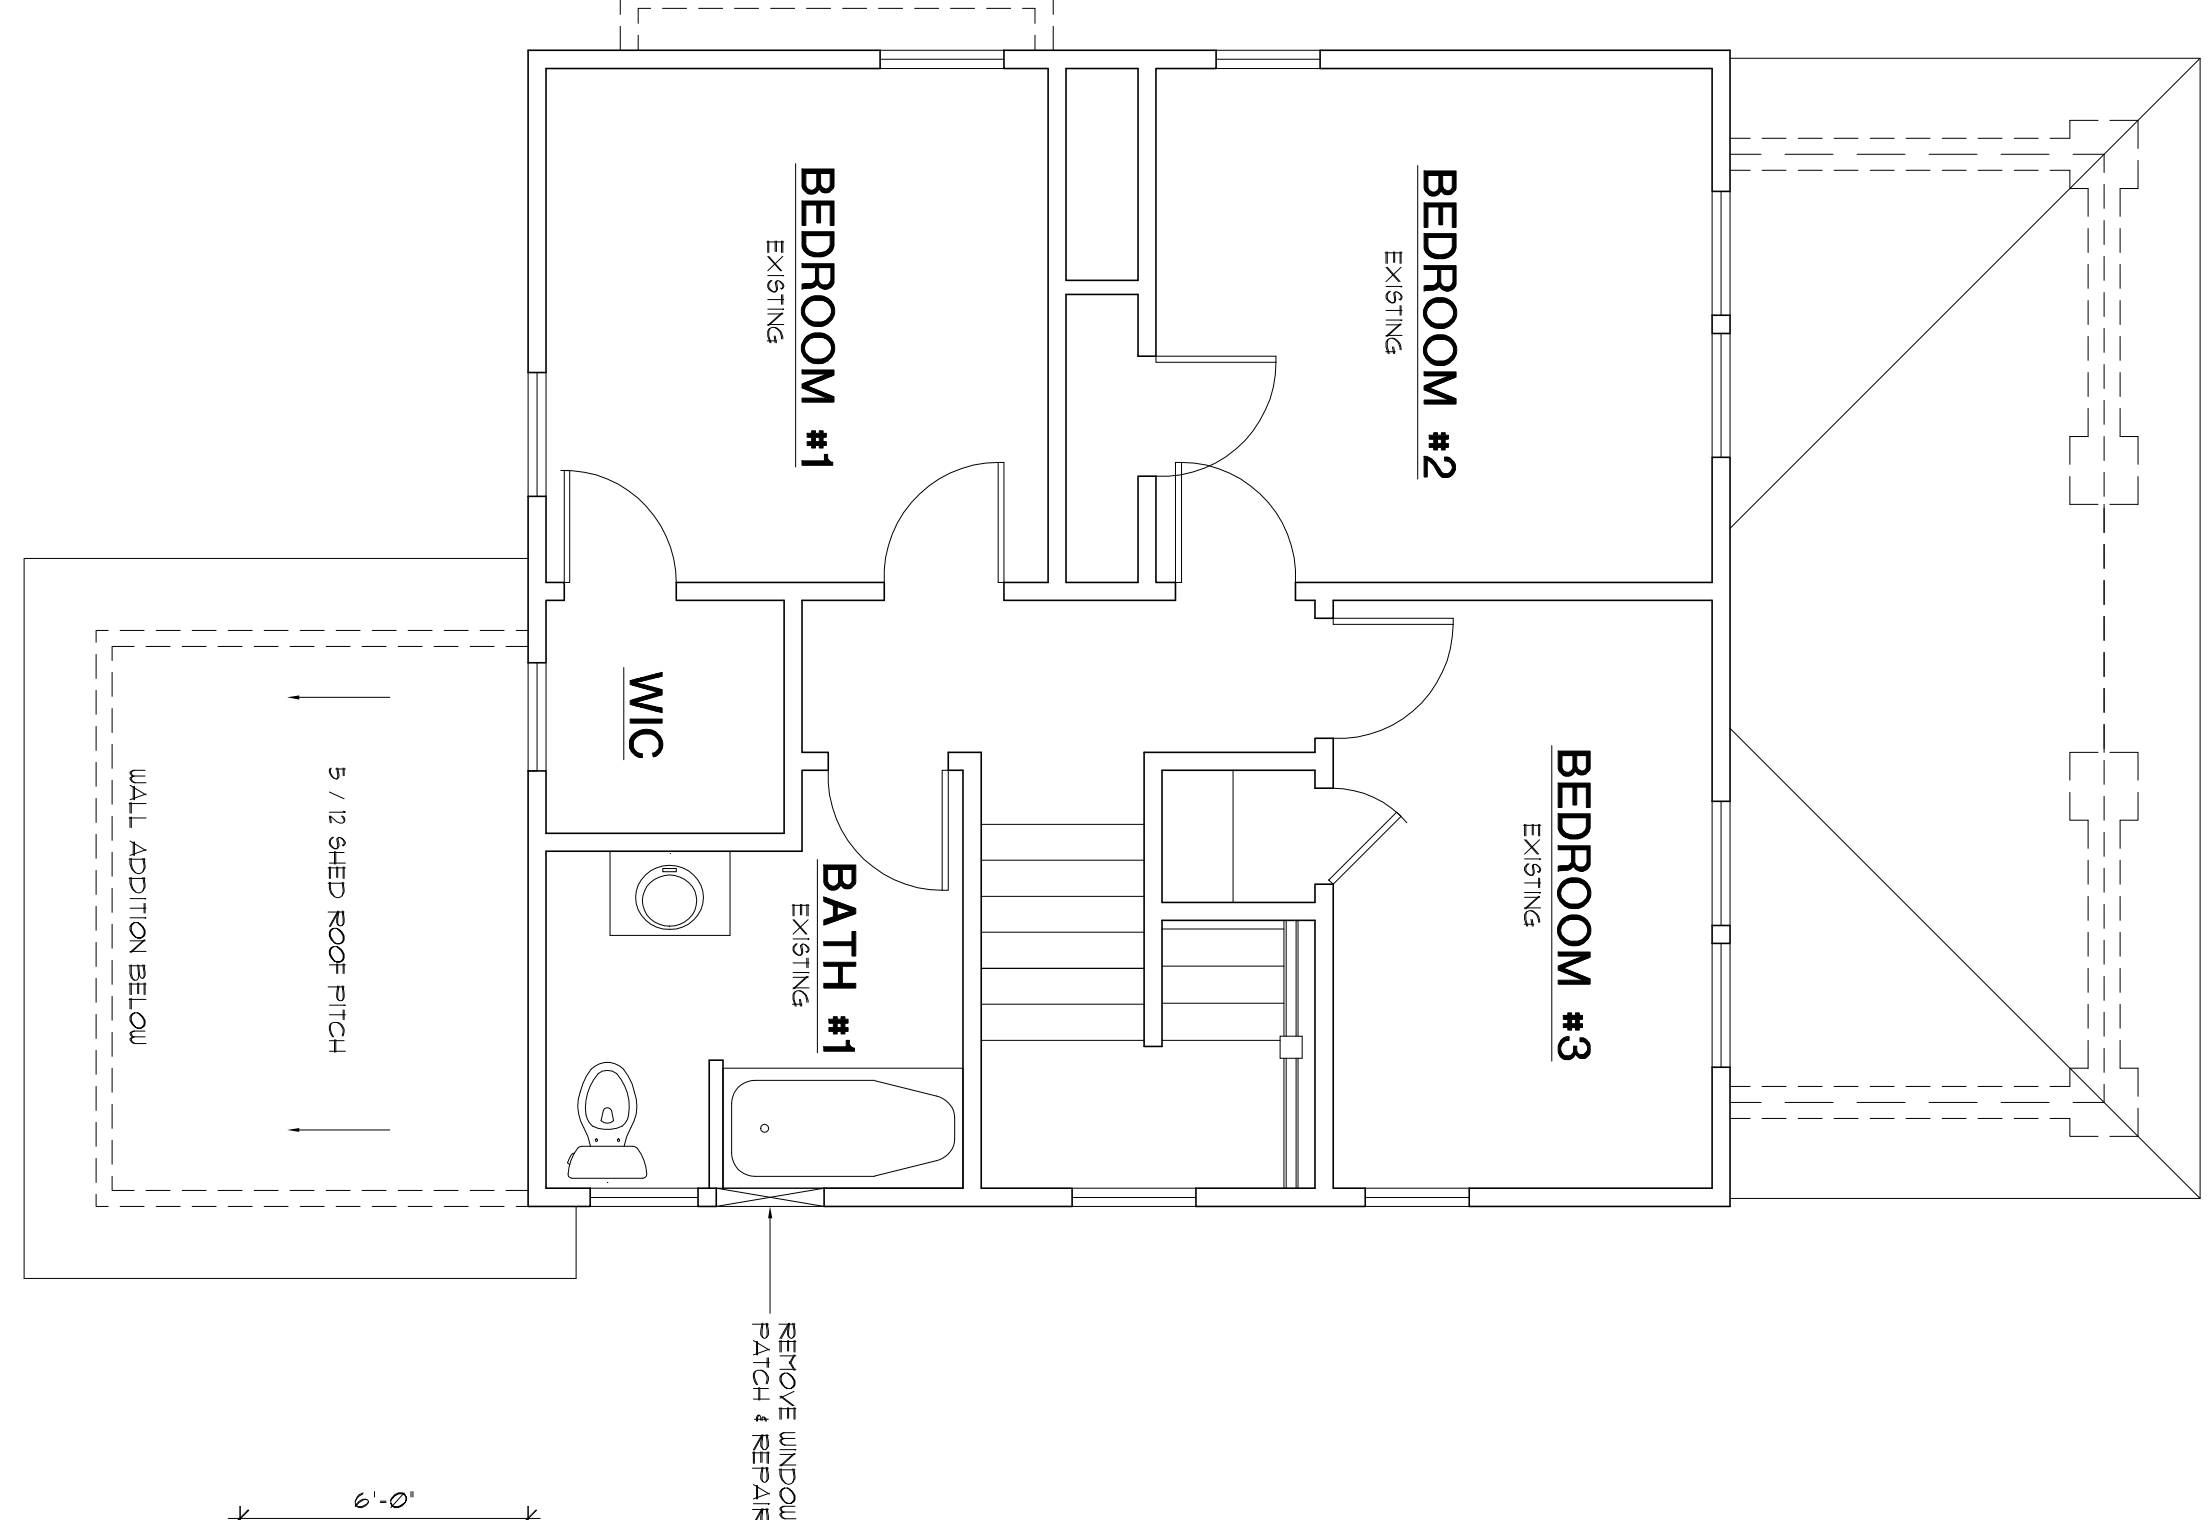

# AS-BUILT SECOND FLOOR PLAN

SCALE: 1/4" = 1'-0"

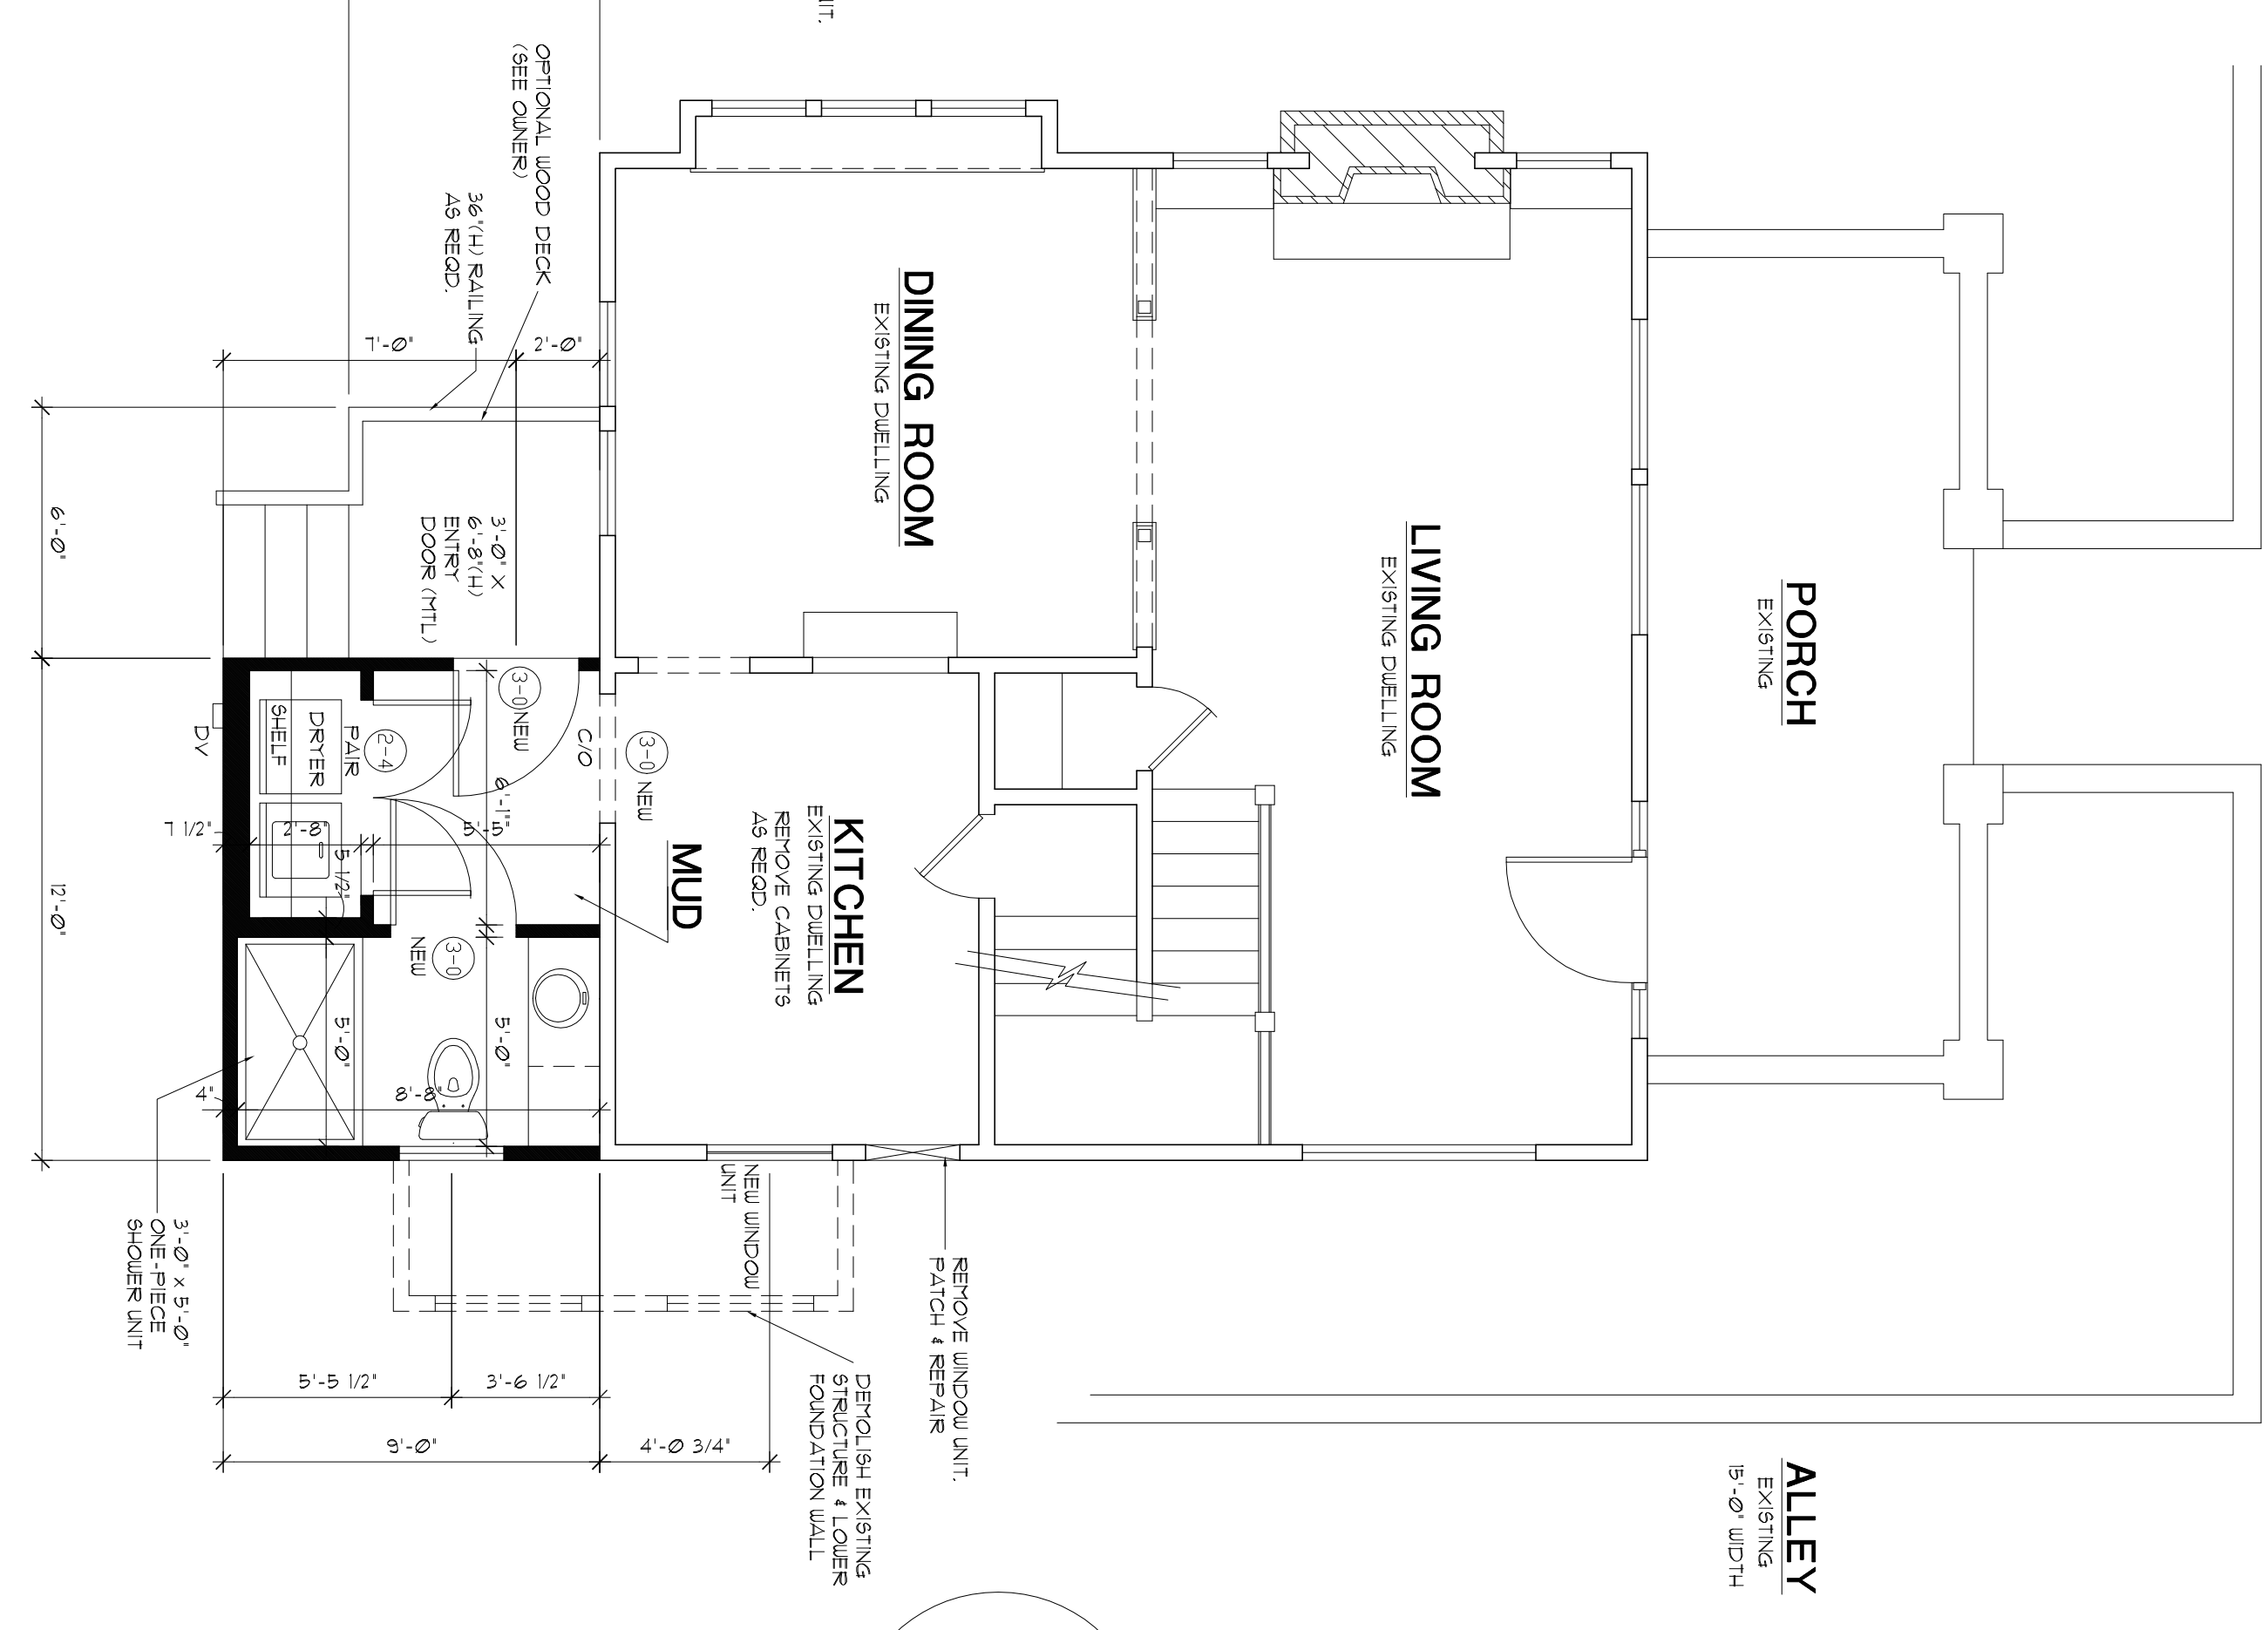

# REVISED FIRST FLOOR PLAN

SCALE: 1/4" = 1'-0"

108 FINISHED SQ. FT.

ALL DIMENSIONS, MEASUREMENT, QUANTITIES, TO BE VERIFIED BY EACH CONTRACTOR, VENDOR, BUILDER, ETC...

ALL STRUCTURAL BEAMS, HEADERS, FOOTINGS, STRUCTURAL WALLS, ETC., TO BE INSPECTED AND / OR SIZED BY LICENSED STRUCTURAL ENGINEER. ALL CURRENT BUILDING CODES TO BE FOLLOWED

SHEET <b>2</b> PLOT DATE: 6/4/10	CLIENT: MAPLETON / FALLCREEK CDC	<b>FORTE DESIGN CO.</b> 4666 FOREST MANOR INDIANAPOLIS, IN 46226 (317) 648-9316	 <b>FORTE DESIGN</b>	CLIENT INT. _____	DATE 00/00/00	REVISIONS
	ADDRESS: 611 E 30 STREET			DATE _____	NOTES OF REVISIONS FOR CLIENT	
ADDRESS: INDIANAPOLIS, IN						